

УКРАЇНА



UKRAINE

ОБЛАСНЕ КОМУНАЛЬНЕ ПІДПРИЄМСТВО ЛЬВІВСЬКОЇ ОБЛАСНОЇ РАДИ  
«БЮРО ТЕХНІЧНОЇ ІНВЕНТАРИЗАЦІЇ ТА ЕКСПЕРТНОЇ ОЦІНКИ»

Затв. наказом Державного комітету України по житлово-комунальному господарству №56 від 15.09.1992р.

Область Львівська

Місто (селище, село) Львів

Інвентарний номер

78

Район Лаврівський

Реєстровий номер

# ТЕХНІЧНИЙ ПАСПОРТ

на Будинок жит. А-1

за адресою: м. Львів

вул. Ковчальська, № 114

Об'єкт нерухомого майна зареєстрований \_\_\_\_\_

На праві \_\_\_\_\_ власності  
(приватної, спільної (сумісної часткової))

на підставі \_\_\_\_\_

і записаний у реєстрову книгу № \_\_\_\_\_ за № \_\_\_\_\_

від " \_\_\_\_\_ " \_\_\_\_\_ 200 р.

Паспорт складений " 18 " 06 200 9 р.




Директор [Signature] /П.Кравець/

До відома власника

1. Технічний паспорт з додатком до свідоцтва про право власності на об'єкт нерухомого майна.
2. Переоформлення технічного паспорта проводиться в зв'язку з переплануванням та переобладнанням приміщень.

# ПОВЕРХОВИЙ ПЛАН М 1:100 (200)

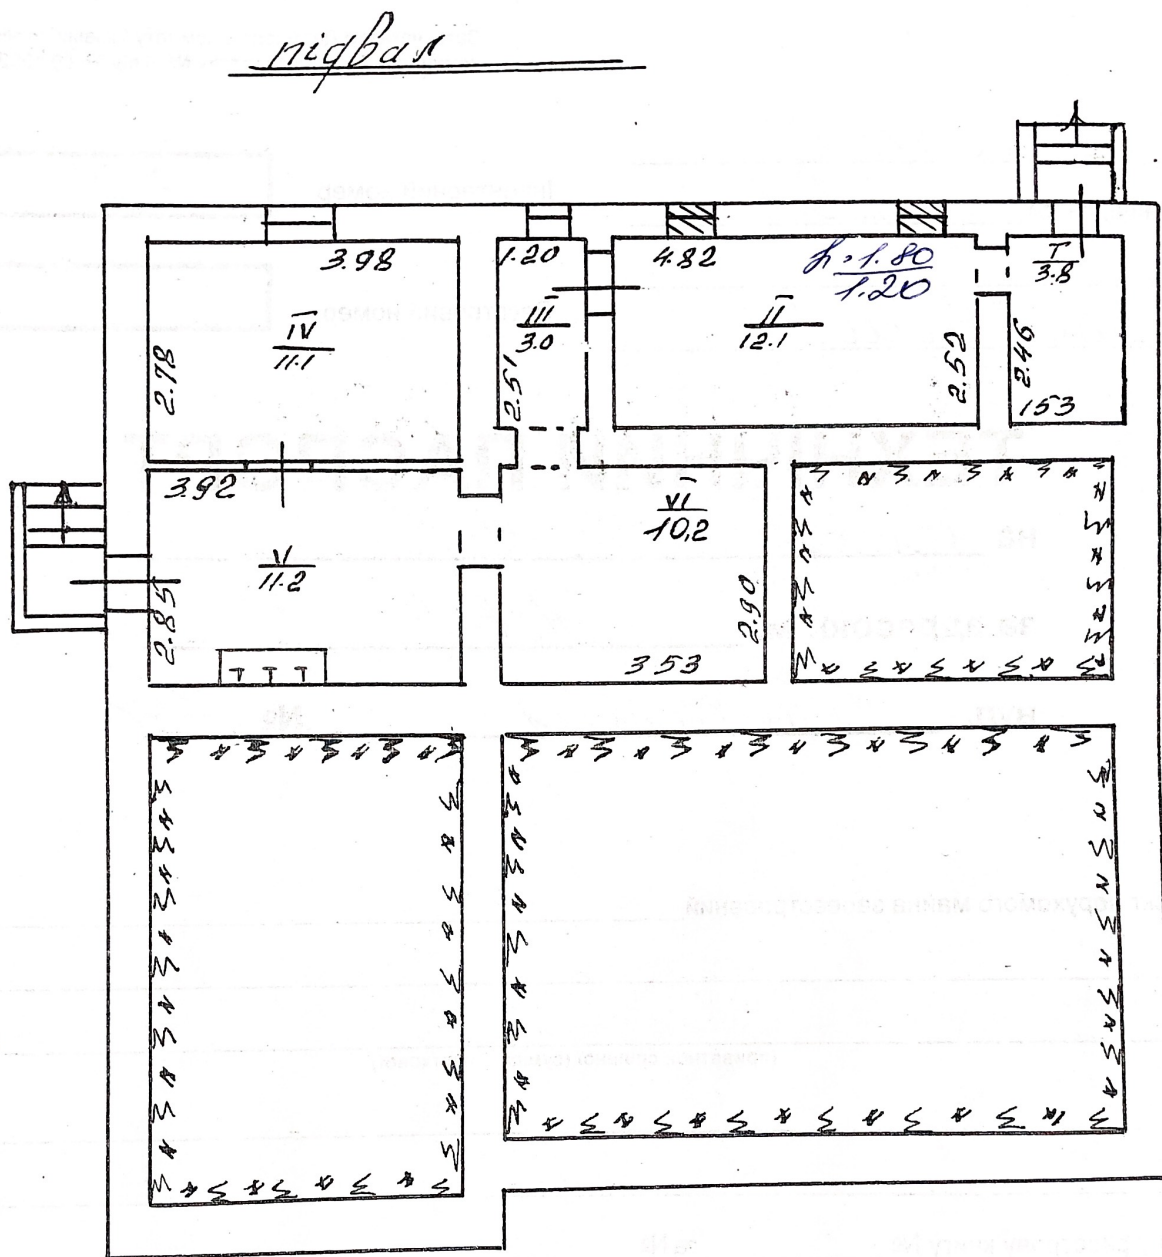

## ТЕХНІЧНА ХАРАКТЕРИСТИКА

Загальна площа 190.0 кв.м. Висота приміщень 1.80 ' 2.30 м

Відновлена вартість \_\_\_\_\_ грн

матеріал зовнішніх стін цегла матеріал перекриття бетон, дерев'яні

Обладнано: водопроводом (холодним, гарячим), каналізацією, газопостачанням, опаленням, електросвітленням, радіотрансляційною мережею, сміттєвідводом, ліфтом.

Склав: С. Б. Костюк Перевірив: С. М. Степаненко (вказати яким)

дата \_\_\_\_\_ дата \_\_\_\_\_

Hand-drawn floor plan of a building with 14 numbered rooms. The plan includes dimensions for each room and overall building dimensions. Rooms are numbered 1 through 14 in red ink. Dimensions are given in feet and inches. The overall dimensions are 13.90 by 12.76. The plan shows a central corridor and several rooms of varying sizes. Room 1 is a large room on the right. Room 2 is a small room above room 1. Room 3 is a small room to the left of room 2. Room 4 is a small room to the left of room 3. Room 5 is a small room to the left of room 4. Room 6 is a small room to the left of room 5. Room 7 is a small room to the left of room 6. Room 8 is a large room on the left. Room 9 is a small room above room 8. Room 10 is a small room to the right of room 9. Room 11 is a small room to the right of room 10. Room 12 is a small room to the right of room 11. Room 13 is a small room to the right of room 12. Room 14 is a small room to the right of room 13. The plan also shows a central corridor and several rooms of varying sizes. The overall dimensions are 13.90 by 12.76.